
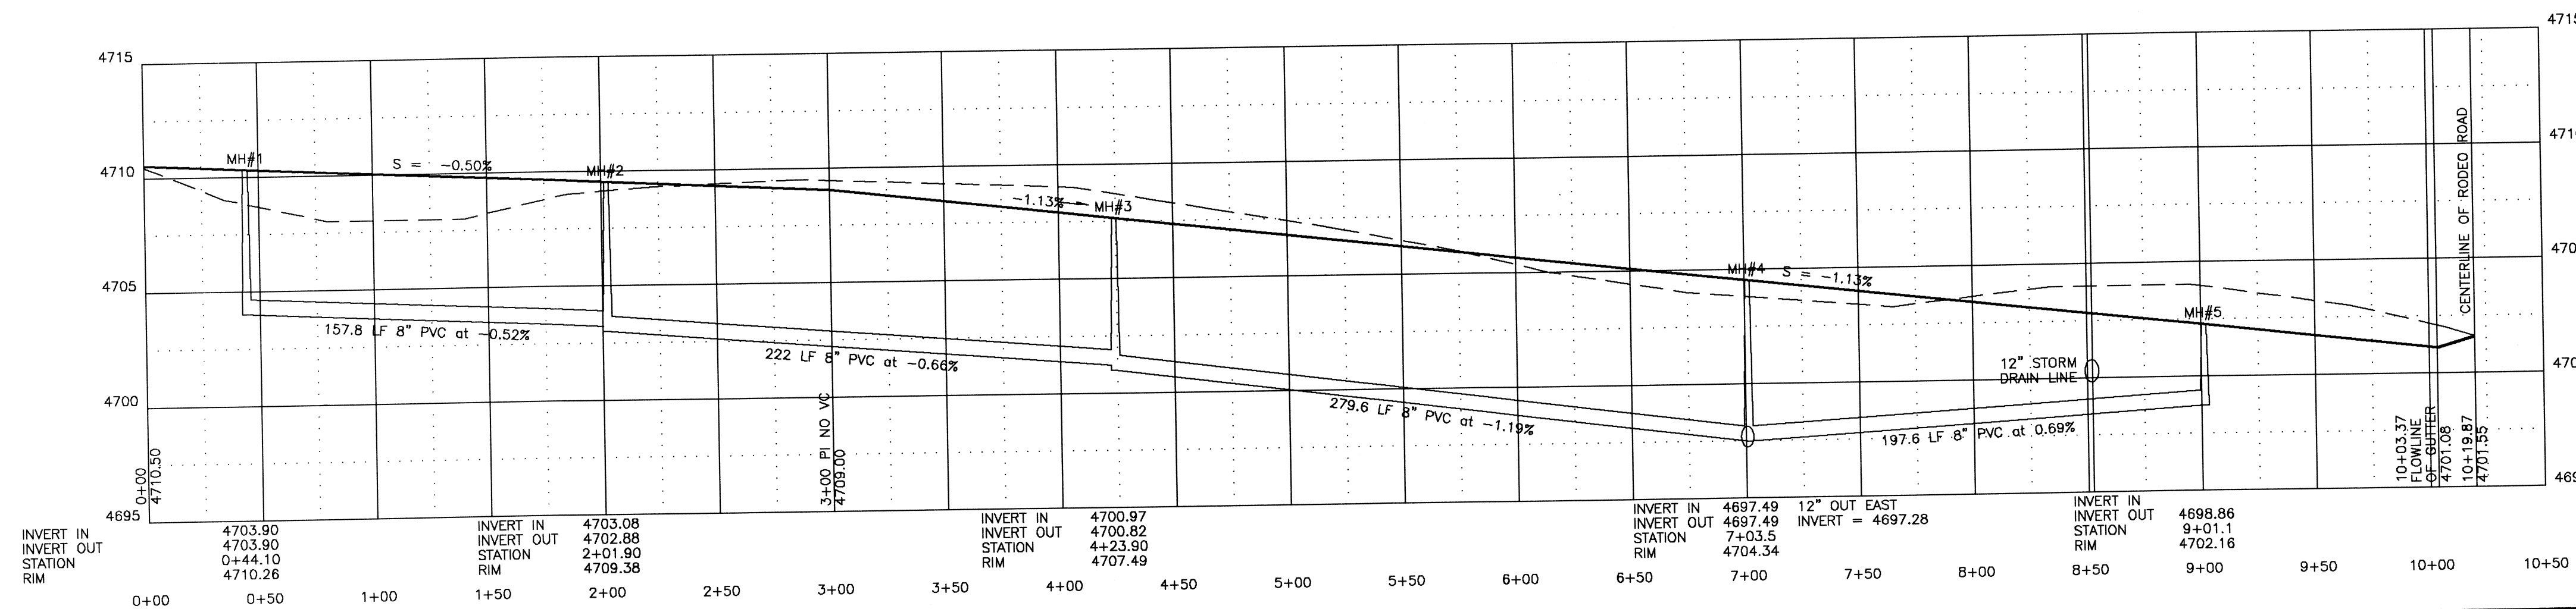
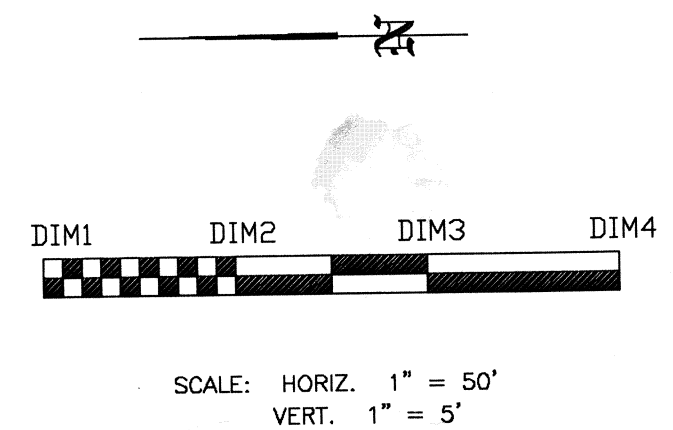



SEE WATER LINE PROFILE CROSSING HIGHWAY AT BOTTOM OF THIS SHEET

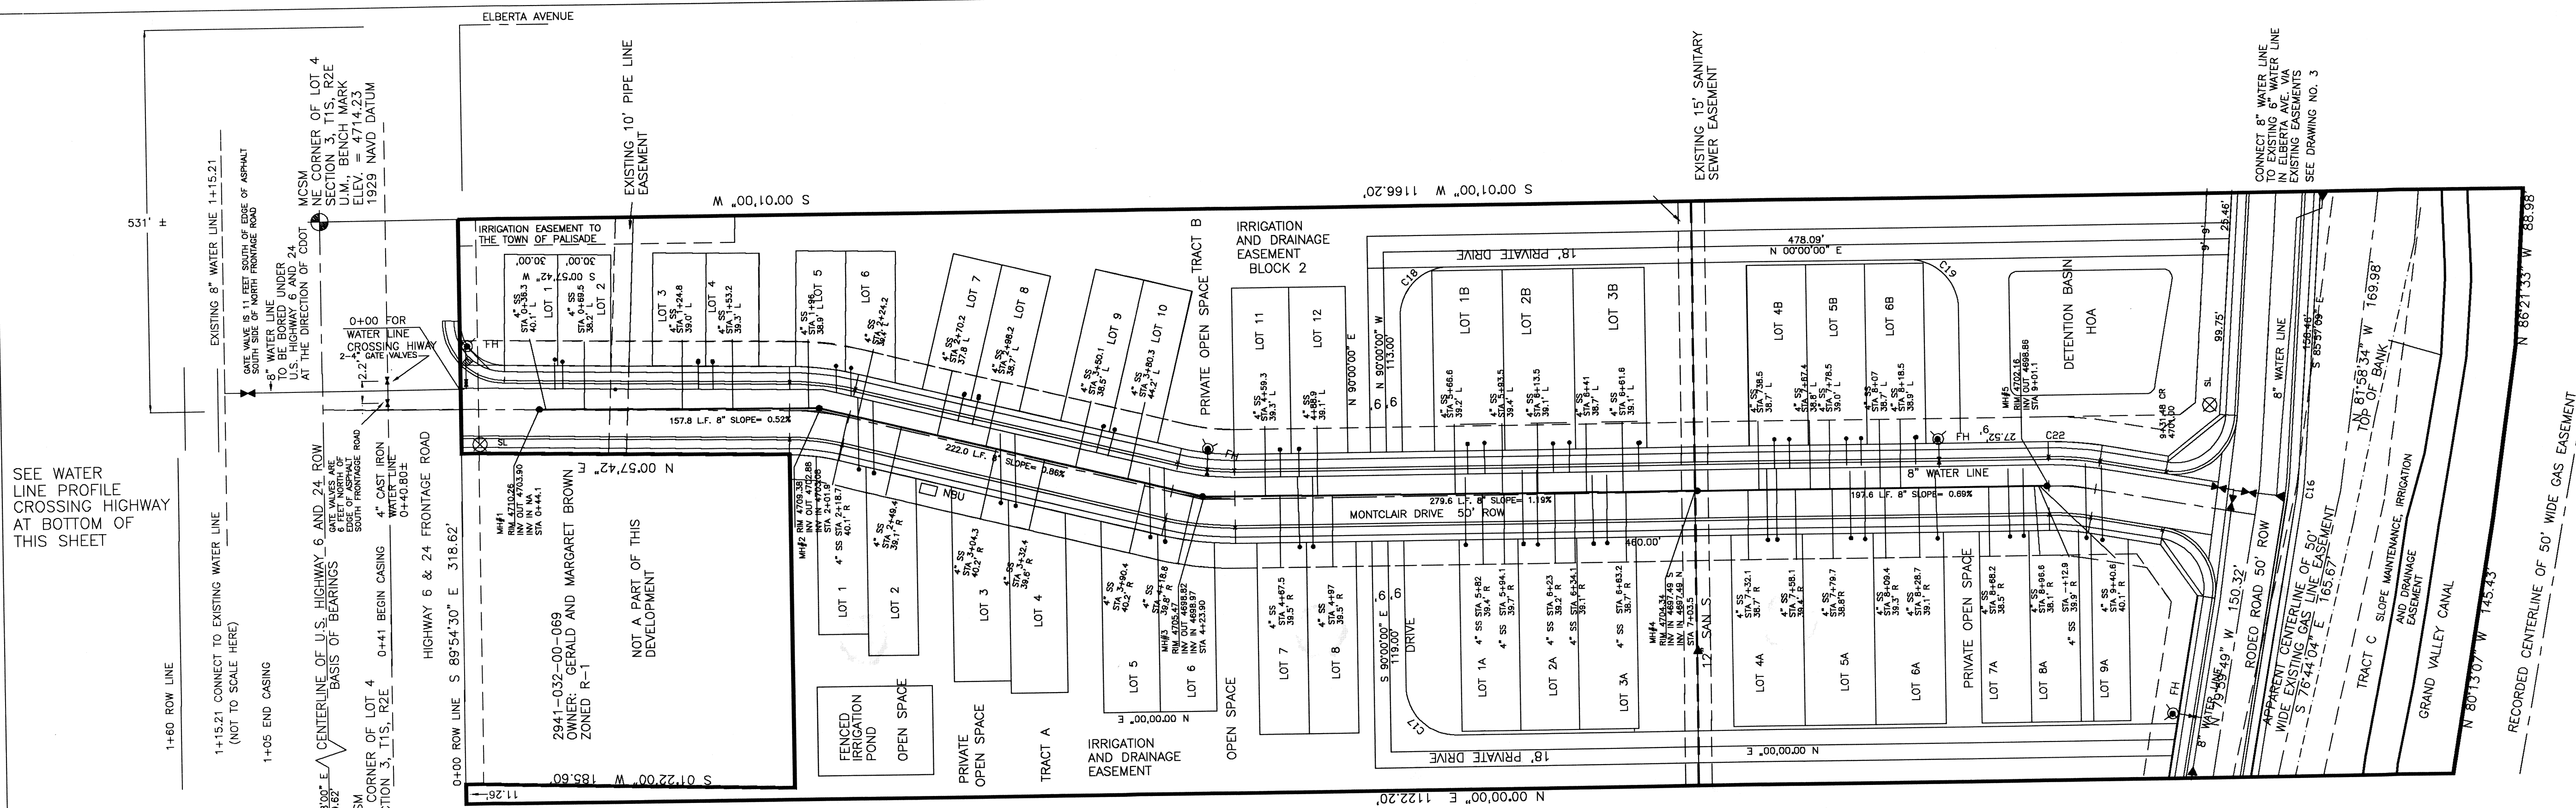

- NOTE
1. ALL CITY OF GRAND JUNCTION SPECIFICATIONS SHALL BE USED FOR THE CONSTRUCTION OF THE WATER LINES AND SEWER LINES.
 2. THE MINIMUM COVER OVER WATER LINES SHALL BE ACCORDING TO THE TOWN OF PALISADE REQUIREMENTS.
 3. BENCH MARK IS TOP OF MESA COUNTY BRASS CAP LOCATED AT THE NORTHEAST CORNER OF LOT 4 OF SECTION 3, T1S, R2E, U.M. ELEVATION = 4614.23, 1929 NGVD DATUM
 4. THE CONTRACTOR IS TO MARK AN 'S' FOR SEWER AND 'W' FOR WATER ON THE SLOPED FACE OF THE DRIVEWAY COMING OUT OF THE GUTTER

LEGEND

- FH PROPOSED FIRE HYDRANT
▽ WATER VALVE
▶ THURST BLOCK FOR WATER LINES, FLOW DIRECTION FOR SEWER LINES
— 3/4" WATER SERVICE LINE WITH METER PALISADE MAY REQUIRE MULTIPLE METERS
— 4" SS 4" SANITARY SEWER SERVICE LINE

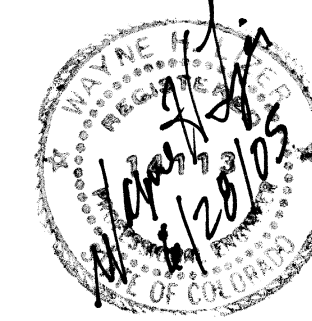

SEE SHEET _____ FOR STREET SECTION

AS-BUILT SANITARY SEWER AND WATER 6/28/05

- NOTES:
1. ALL GRADES AND STATIONING IS TO THE FLOWLINE OF GUTTER
 2. BENCHMARK IS A MESA COUNTY BRASS CAP AT THE NORTHEAST CORNER OF LOT 4 OF SECTION 3, T1S, R2E, U.M. ELEVATION = 4714.23, NGVD 1929 DATUM

WATER LINE CROSSING HIGHWAY 6 AND 24 NOTES

1. ALL CONSTRUCTION SHALL BE DONE ACCORDING TO COLORADO DEPARTMENT OF TRANSPORTATION (CDOT) SPECIFICATIONS.
2. A 12" STEEL CASING WILL BE REQUIRED FOR THE WATER LINE CROSSING.
3. WATER LINE PIPE MATERIAL FOR THE CROSSING SHALL BE C900 WATER LINE PIPE.
4. CONTRACTOR TO LOCATE AND PROTECT ALL UTILITIES BEING CROSSED FOR THE WATER LINE. THE INSTALLATION OF THE WATER LINE SHALL BE ACCOMPLISHED BY BORING AND INSTALLING THE CARRIER PIPE THROUGH THE CASING.
5. THE DEPTHS OF THE EXISTING WATER LINES ARE APPROXIMATE ONLY. THE ACTUAL DEPTHS OF THE WATER LINES ARE TO BE VERIFIED PRIOR TO CONSTRUCTION AS WELL AS ANY OTHER BURIED UTILITIES. SAID WORK IS TO BE DONE BY THE CONTRACTOR AND THE INFORMATION GIVEN TO THE ENGINEER IN ORDER TO MAKE ANY GRADE CHANGES OF THE WATER LINE IF NECESSARY.

LEGEND

- ⊗ SL STREET LIGHT
□ NBU NEIGHBORHOOD BOX UNIT POSTAL DELIVERY

SHEET 1 OF 1


REVISED 6/28/05 TO SHOW SANITARY SEWER AND WATER AS-BUILTS

SANITARY SEWER AND WATER PLAN AND PROFILE
PREPARED FOR B & B CONSTRUCTION SERVICES, INC.
MONTCLAIR SUBDIVISION
SITUATED IN THE E 1/4 OF LOT 4, SECTION 3, T1S, R2E, U.M.
PALISADE, MESA COUNTY, COLORADO


W.H. LIZER AND ASSOCIATES
ENGINEERING CONSULTING AND LAND SURVEYING
576 25 ROAD-UNIT 8
GRAND JUNCTION, COLORADO

| DATE: | PROJ. NO. | SCALE: | FILE NAME: | DRAWN BY: | CHECKED BY: |
|--------|-----------|--------|------------|-----------|-------------|
| 9/4/04 | 033992-10 | 1"=50' | MONT17 | WHL | WHL |

DRAWING NO. 7

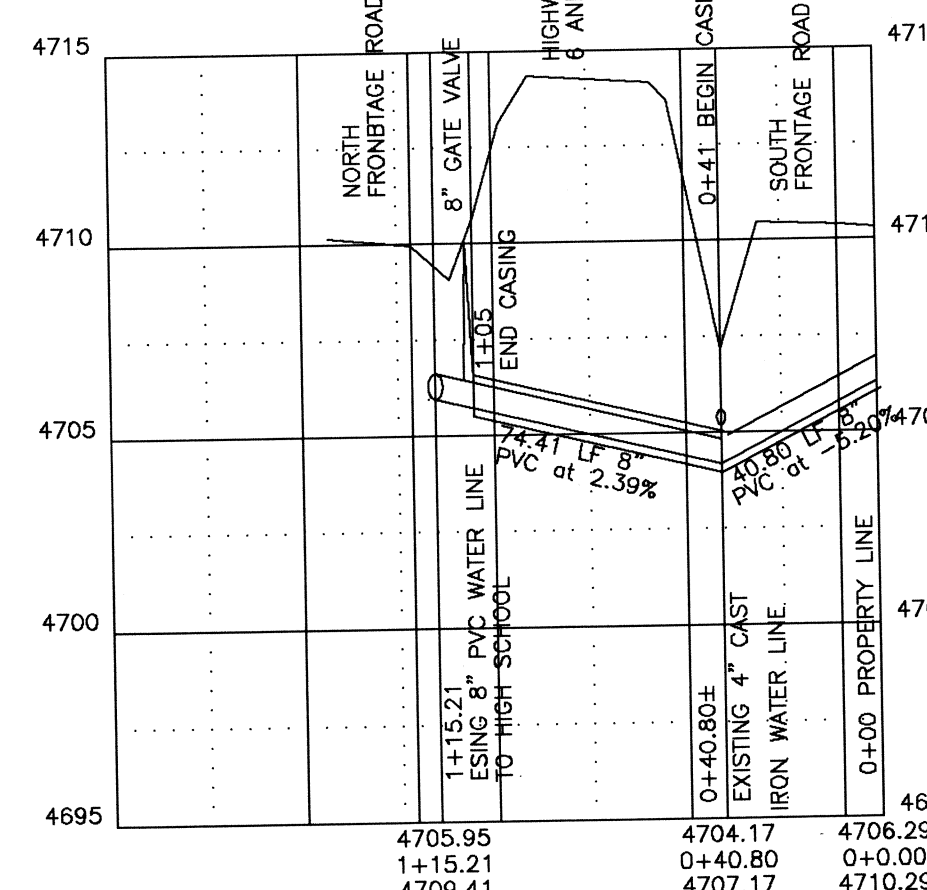

HIGHWAY 6 AND 24 HIGHWAY CROSSING OF WATER LINE
8" WATER LINE FROM THE NORTH SIDE OF MONTCLAIR SUBDIVISION TO THE 8" WATER LINE TO PALISADE HIGH SCHOOL

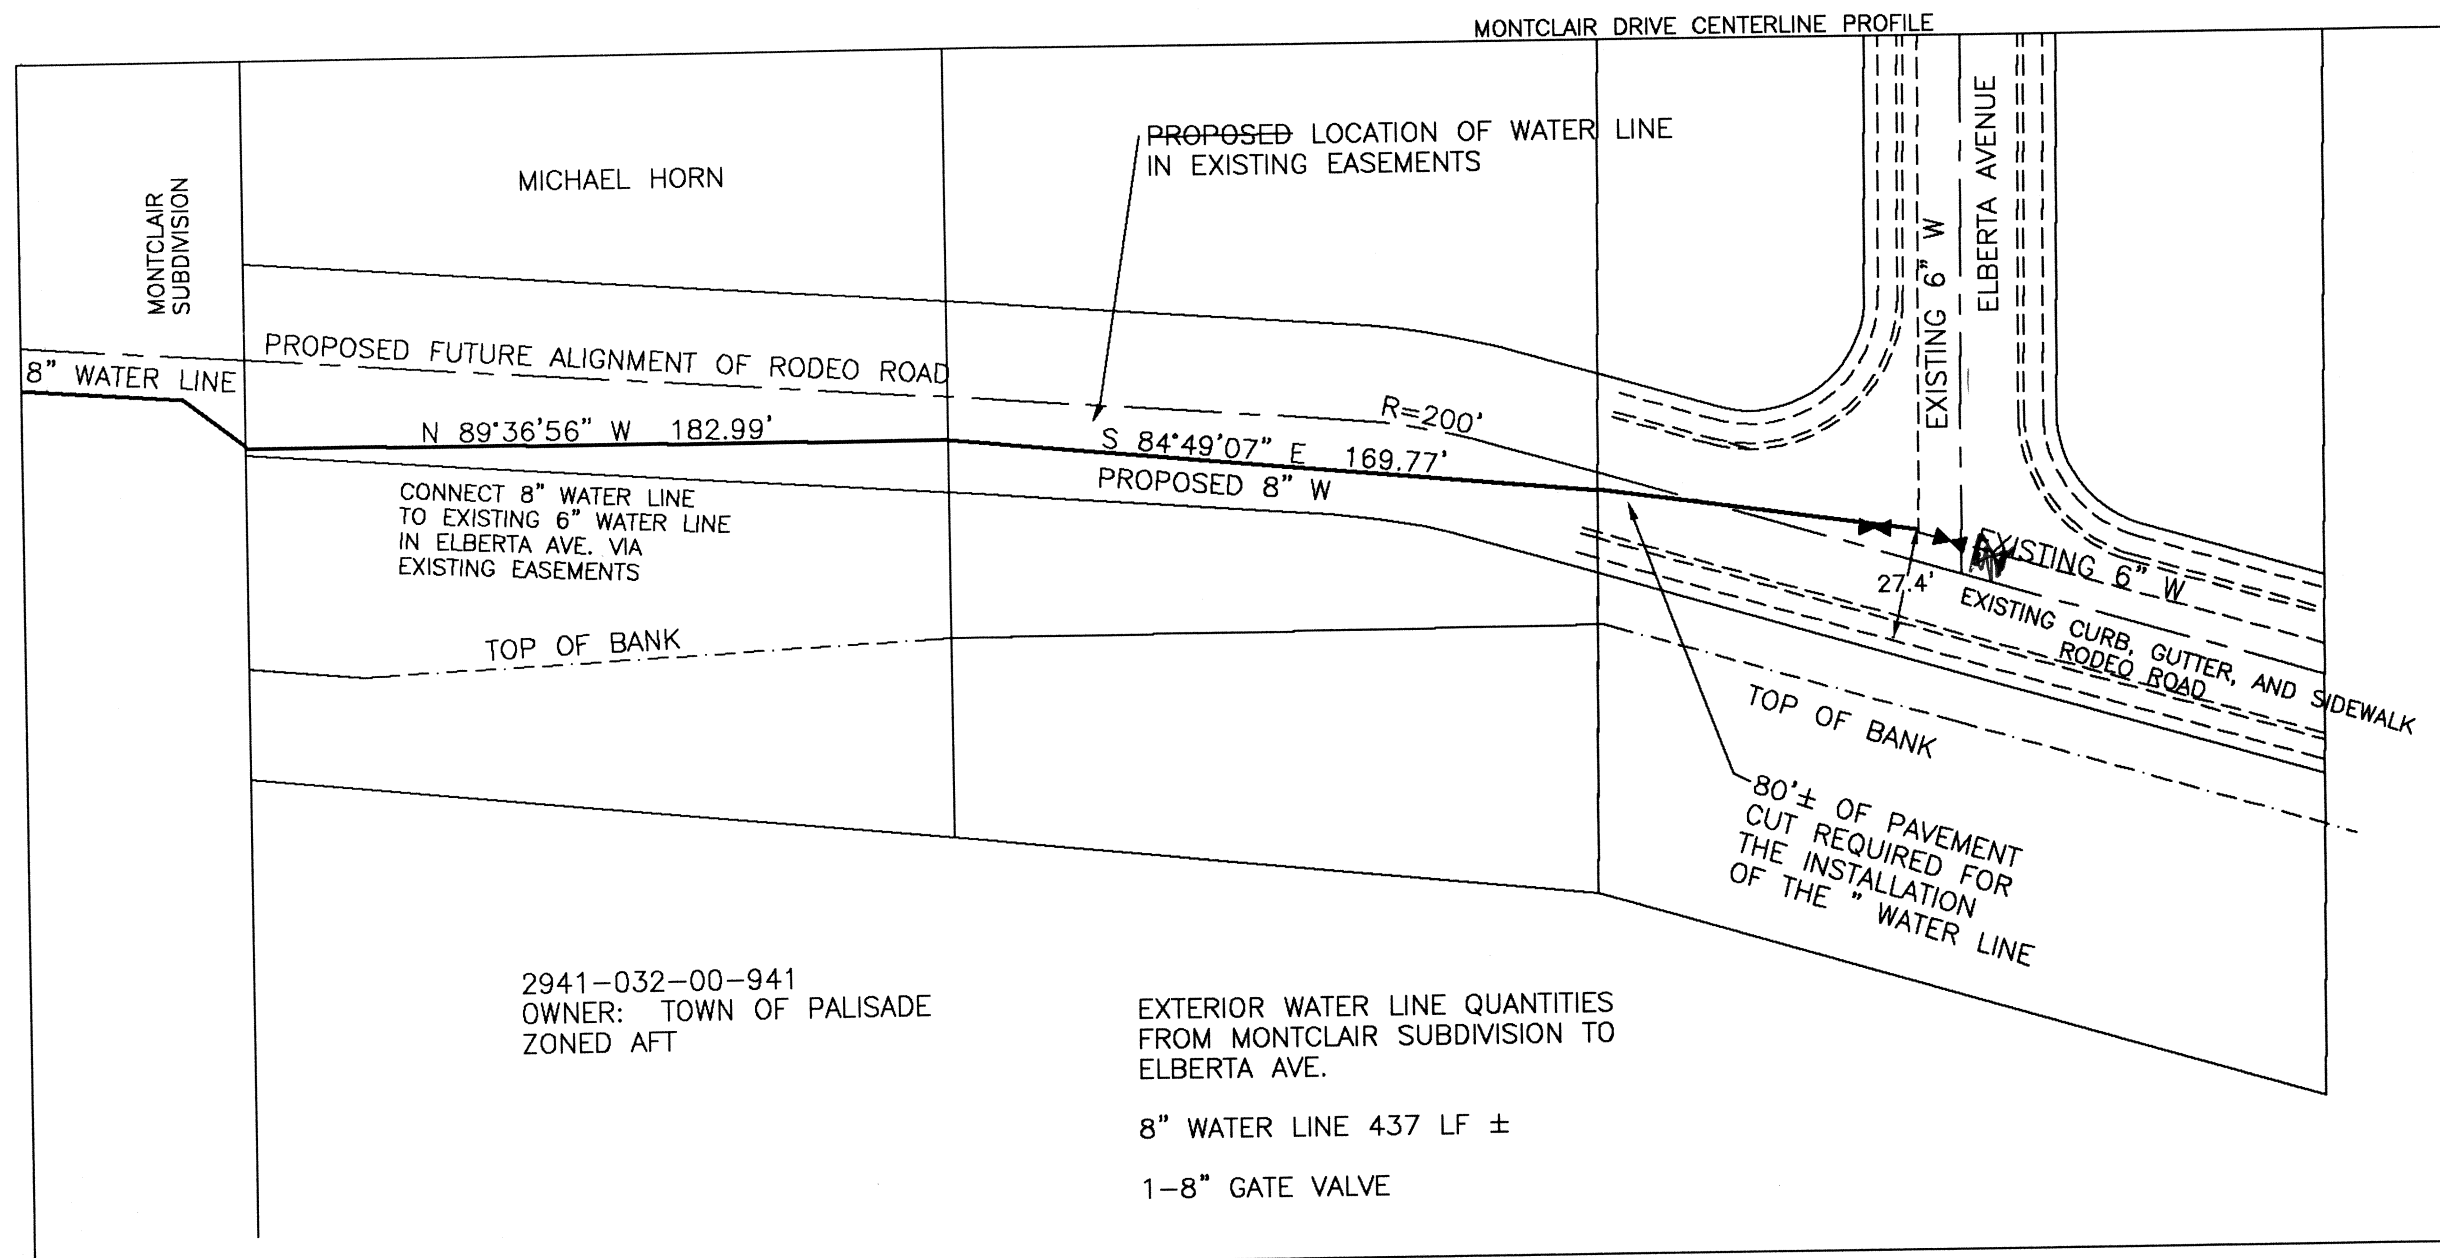

2941-032-00-941
OWNER: TOWN OF PALISADE
ZONED AFT

EXTERIOR WATER LINE QUANTITIES
FROM MONTCLAIR SUBDIVISION TO
ELBERTA AVE.

8" WATER LINE 437 LF ±
1-8" GATE VALVE